

RFI #Constr-412: CS - Deletion of Bulletin 2 Roof Duct Enclosure Under Dunnage

Revision	0	Status	Open
To	Lisa Foster (HKS Architects, P.C) Michael Miller (HKS Architects, P.C)	From	Dan Thorley (Joint Venture - Torcon/P Agnes) 101 Haddon Ave Camden, New Jersey 08103
Date Initiated	Oct 24, 2025	Due Date	Nov 2, 2025
Location		Project Stage	07 - Construction
Cost Impact		Schedule Impact	
Spec Section		Cost Code	
Drawing Number	A1.11, A6.33, A7.04	Reference	
Linked Drawings			
Received From	Dan Thorley (Joint Venture - Torcon/P Agnes)		
Copies To	Antonio Andreoni (Joint Venture - Torcon/P Agnes), Thomas Buklarewicz (Joint Venture - Torcon/P Agnes), Pam Chiaradia (Joint Venture - Torcon/P Agnes), Christopher Collett (Joint Venture - Torcon/P Agnes), Lisa Foster (HKS Architects, P.C), Hanna Gold (Pure Project Management), Christian Hochstetler (Joint Venture - Torcon/P Agnes), Dave Hontz (Joint Venture - Torcon/P Agnes), Steve Kafasis (Joint Venture - Torcon/P Agnes), Ron Keyak (Joint Venture - Torcon/P Agnes), Bill Lawyer (Joint Venture - Torcon/P Agnes), Michael Miller (HKS Architects, P.C), Greg Portner (Pure Project Management), Samantha Purdom (Joint Venture - Torcon/P Agnes), Dan Thorley (Joint Venture - Torcon/P Agnes)		

Activity

Question

Question from Dan Thorley Joint Venture - Torcon/P Agnes on Friday, Oct 24, 2025 at 12:01 PM EDT

Reference drawing A1.11, A6.33, A7.04, Response to RFI#Constr-313:

After review on Bulletin 2 costs to add roof duct enclosure under dunnage per A1.111, 7/A6.33, and 18/A7.04 it was determined that costs were no acceptable. Response to RFI #Constr-313 raised the dunnage 3'-0" to alleviate need for roof duct enclosure. However BR&A required cost evaluation between the two. See attached ROM pricing for ductwork and structural steel of approx. 40K.

Provide revised Architectural drawings A1.111, A6.33, and A7.04 to delete roof duct enclosure under dunnage.

Attachments

[RFI# Constr-412 Attachment.pdf](#)

Awaiting an Official Response

Raise dunnage and associated HVAC units and ductwork in it's entirety 2'-9". Eliminate ductwork enclosure and extend roofing accordingly. Add additional risers and treads to dunnage access stairs. See attached revisions.
- HT/HKS

RFI #Constr-313: CS - Roof Ductwork and Dunnage Coordination

Revision	0	Status	Open
To	Lisa Foster (HKS Architects, P.C) Michael Miller (HKS Architects, P.C)	From	Antonio Andreoni (Torcon/P. Agnes, a Joint Venture) 101 Haddon Ave Camden, New Jersey 08103
Date Initiated	Jul 25, 2025	Due Date	Aug 1, 2025
Location		Project Stage	07 - Construction
Cost Impact		Schedule Impact	
Spec Section		Cost Code	
Drawing Number		Reference	
Linked Drawings			
Received From	Joseph Esposito (AerDux, Inc.)		
Copies To	Antonio Andreoni (Torcon/P. Agnes, a Joint Venture) , Pam Chiaradia (Torcon/P. Agnes, a Joint Venture), Lisa Foster (HKS Architects, P.C), Hanna Gold (Pure Project Management), Dave Hontz (Torcon/P. Agnes, a Joint Venture), Steve Kafasis (Torcon/P. Agnes, a Joint Venture), Bill Lawyer (Torcon/P. Agnes, a Joint Venture), Michael Miller (HKS Architects, P.C), Charlie Morgan (Torcon/P. Agnes, a Joint Venture), Greg Portner (Pure Project Management), Samantha Purdom (Torcon/P. Agnes, a Joint Venture), Mario Seitaj (Torcon/P. Agnes, a Joint Venture), Dan Thorley (Torcon/P. Agnes, a Joint Venture)		

Activity

Question	Question from Antonio Andreoni Torcon/P. Agnes, a Joint Venture on Friday, Jul 25, 2025 at 11:35 AM EDT Please refer to contract drawing M1.11-CS Ductwork Plan - Penthouse and attached RFI markup. The Ductwork for the Rooftop AHU under the dunnage needs 36" for the installation of the Duct Curbs for the Vertical Risers to be installed off the bottom of the ducts. The amount of space currently in the model is 3" from the ductwork to the roof. See attached snips of the current design. Please confirm dunnage should be raised to meet this clearance for installation. Attachments RFI# Constr-313 Attachment.pdf
-----------------	---

BR+A Response:

During design BR+A proposed embedding this particular ductwork into roofing membrane due to space constraints. The intent was to fully encapsulate the duct within the membrane to ensure a watertight and warrantable installation. It was agreed to have the trades review the implications of this approach once they were onboarded. BR+A's detail included in the RFI attachment is a standard/typical detail for a duct penetrating a roof. This detail applies to most applications but not necessarily all. BR+A recommends a cost evaluation be performed, comparing a roof embedded duct with raising the steel 3 ft, prior to making any changes.

David Staller, BR+A

July 31, 2025

RFI #Constr-313: CS - Roof Ductwork and Dunnage Coordination
Response Con't

O&N Response: We take no exception structurally to raising the dunnage platform +3'-0".

HKS Response:

See O&N and BR+A responses, as well. Per review with the Owner on 8/6/25, no exception taken architecturally to raising the dunnage platform +3'-0".



AERDux, INCORPORATED
240 Benigno Boulevard
Bellmawr, NJ 08031
856-933-2400

REQUEST FOR INFORMATION

To: Torcon/P Agnes A Joint Venture
328 Newman Springs Road
Red Bank, NJ 07701

Date: 7/25/2025
From: Joseph Esposito
Job No: 2517
Job Name: Cooper Tower A
RFI No: #3

Attention: Antonio Andreoni

Priority: ☐ High - Need Answer ASAP ☒ Normal ☐ Low
Response Required By:

Subject: Roof Ductwork vs Dunnage
Discipline: Sheet Metal
Specification Section: 2331000
Drawing No: M1.00-CS, M1.11-CS


Question: The Ductwork for the Rooftop AHU under the dunnage needs 36" for the installation of the Duct Curbs for the Vertical Risers to be installed off the bottom of the ducts. The amount of space currently in the model is 3" from the ductwork to the roof. See attached snips of the current design.

Attachments: Screenshot 1,2,3

Suggested Solution: Raise the Dunnage at Least 36" to allow for the installation of the duct curbs for the riser ductwork.

Copy To: File

Signed: Joseph Esposito

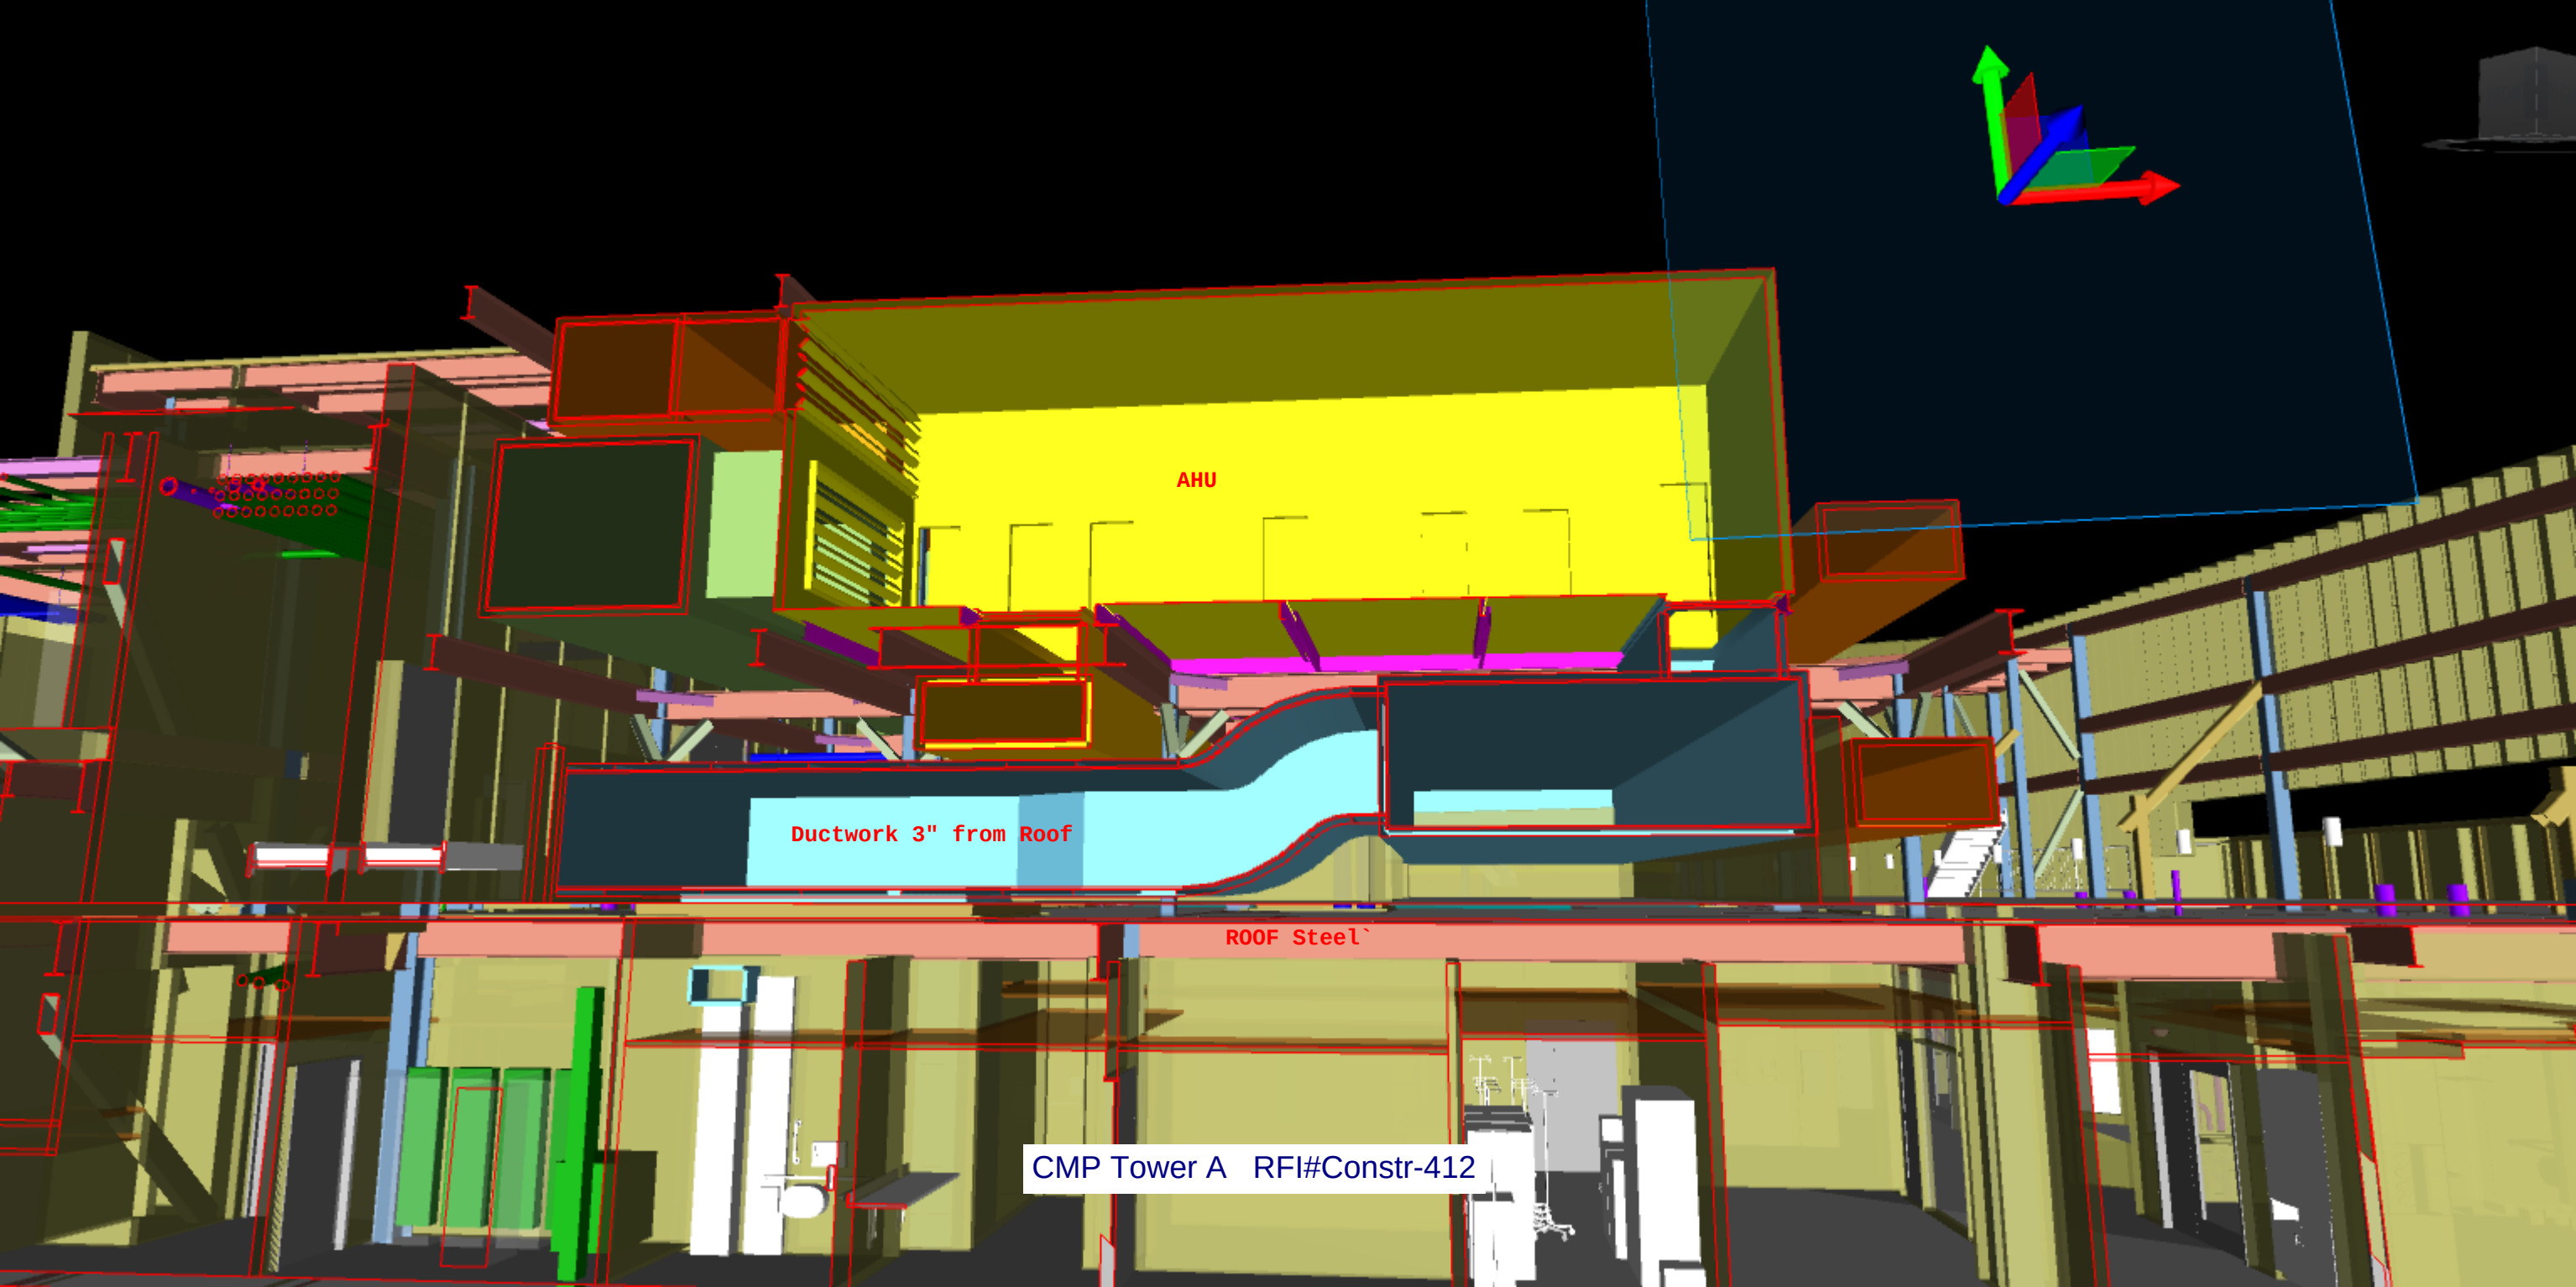


AHU


Ductwork 3" from Roof

R00F Steel


CMP Tower A RFI#Constr-412

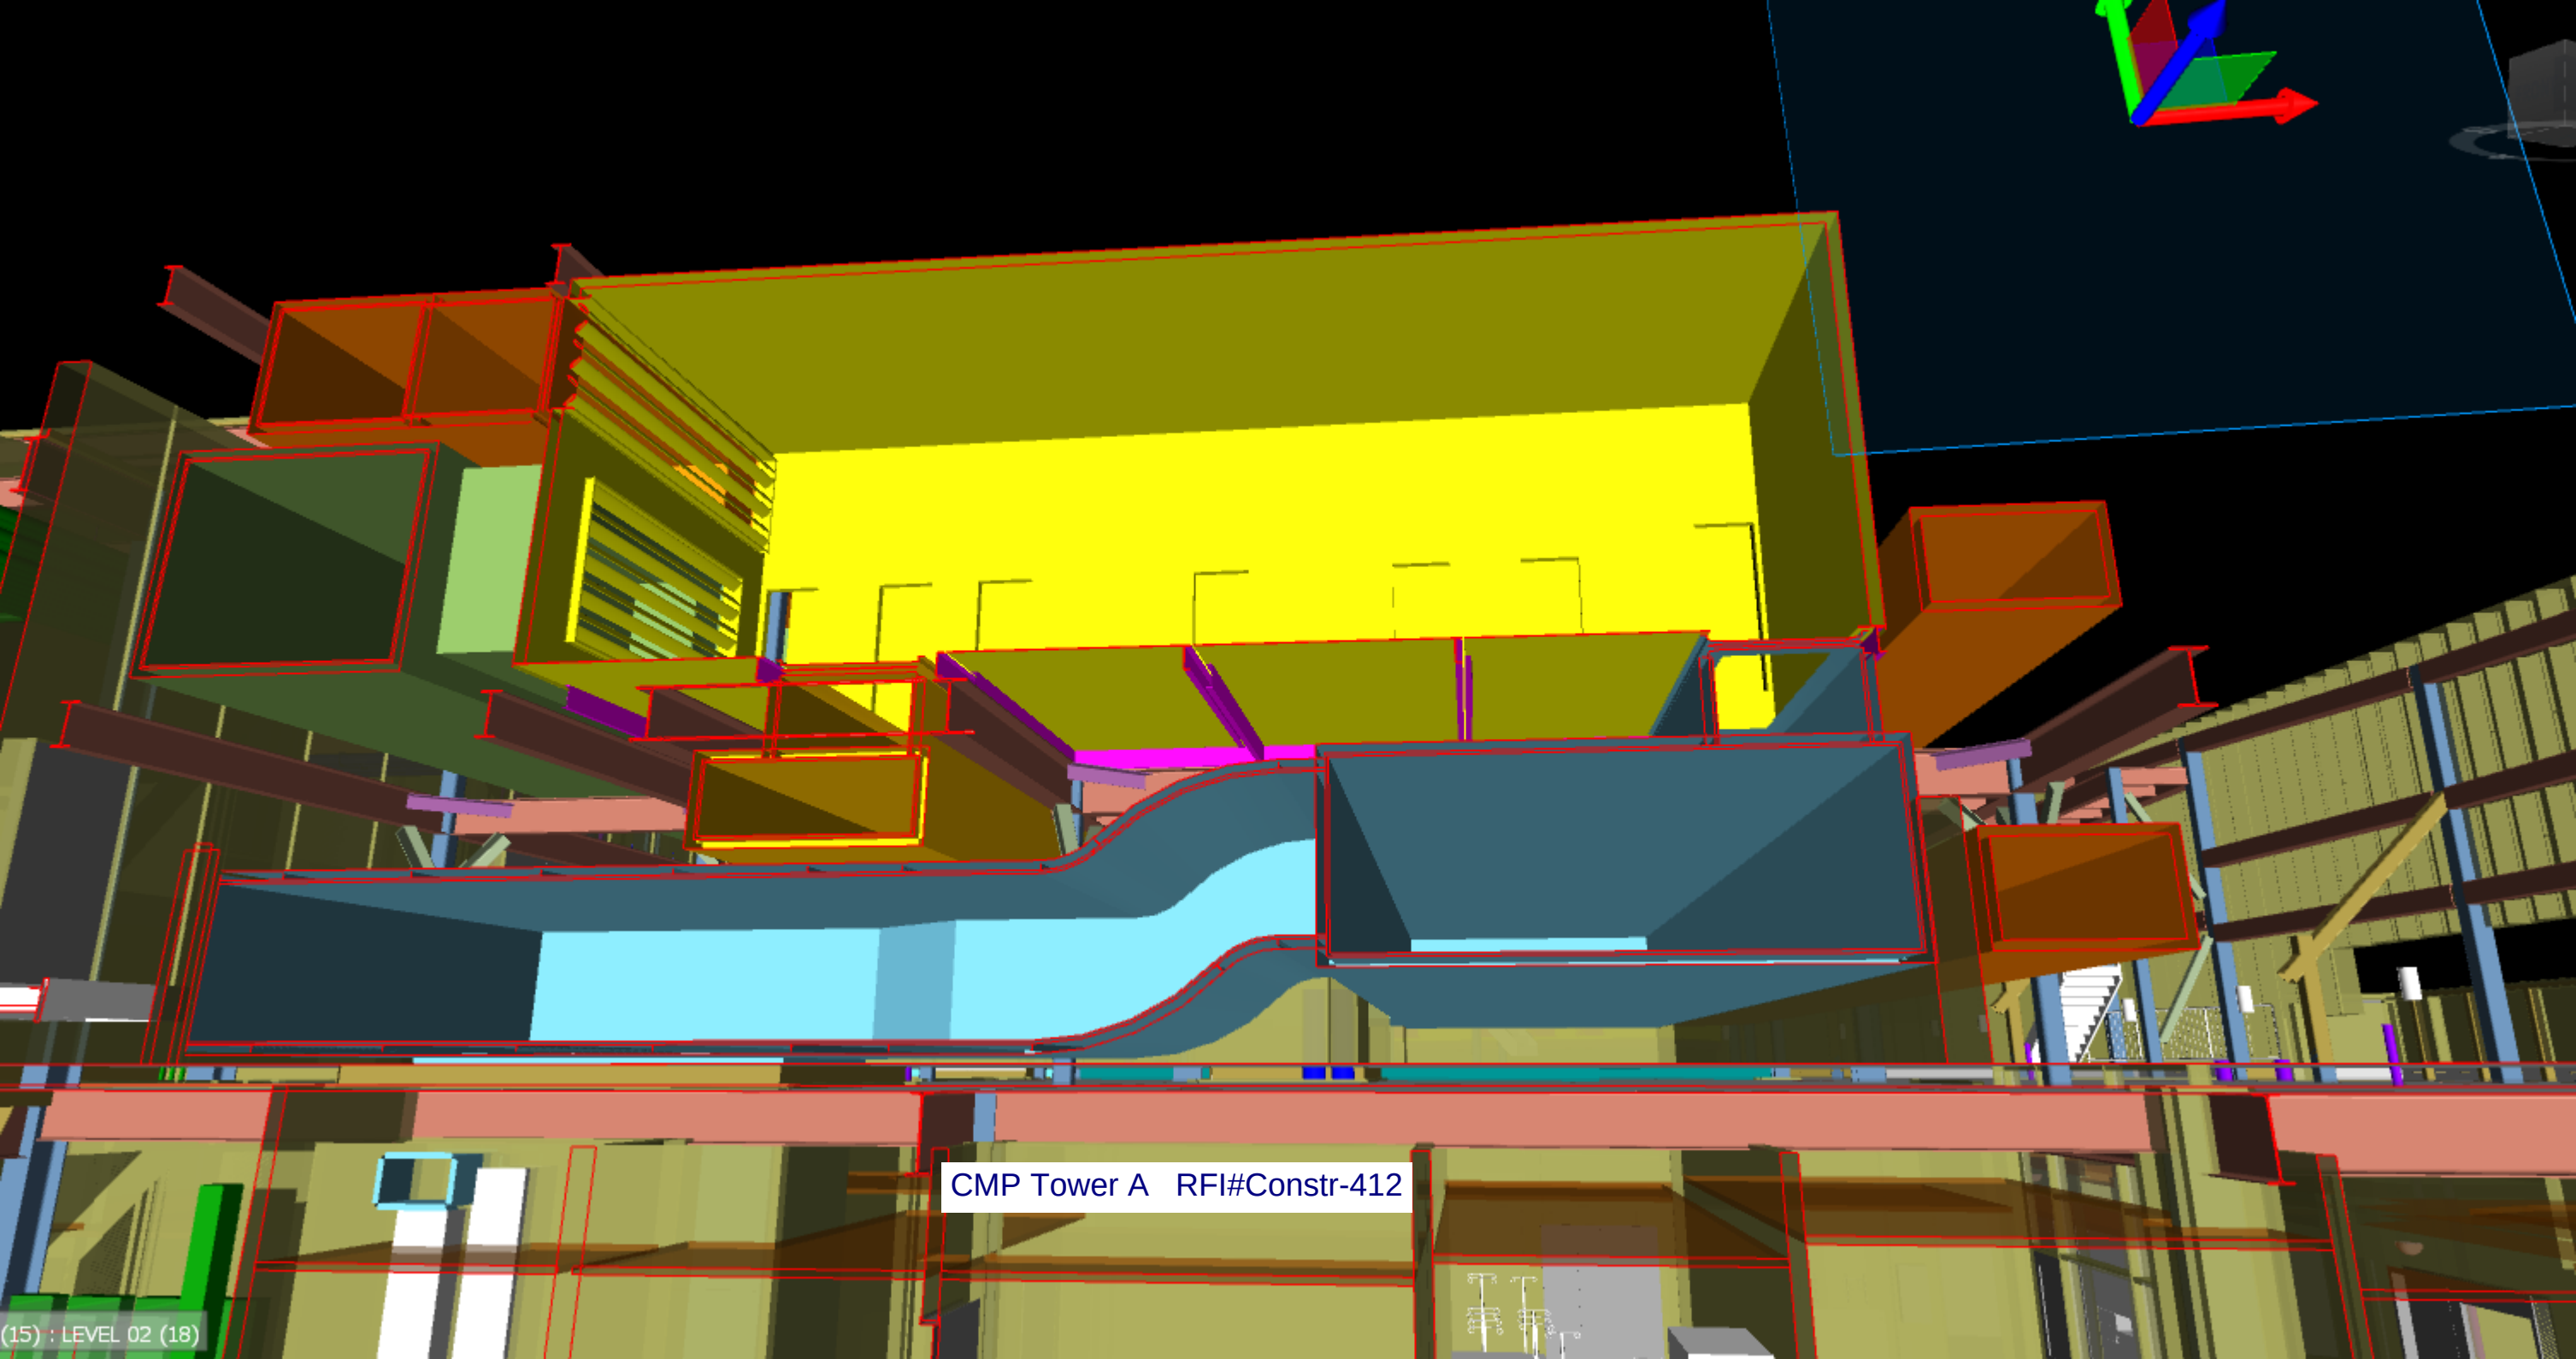

CMP Tower A RFI#Constr-412

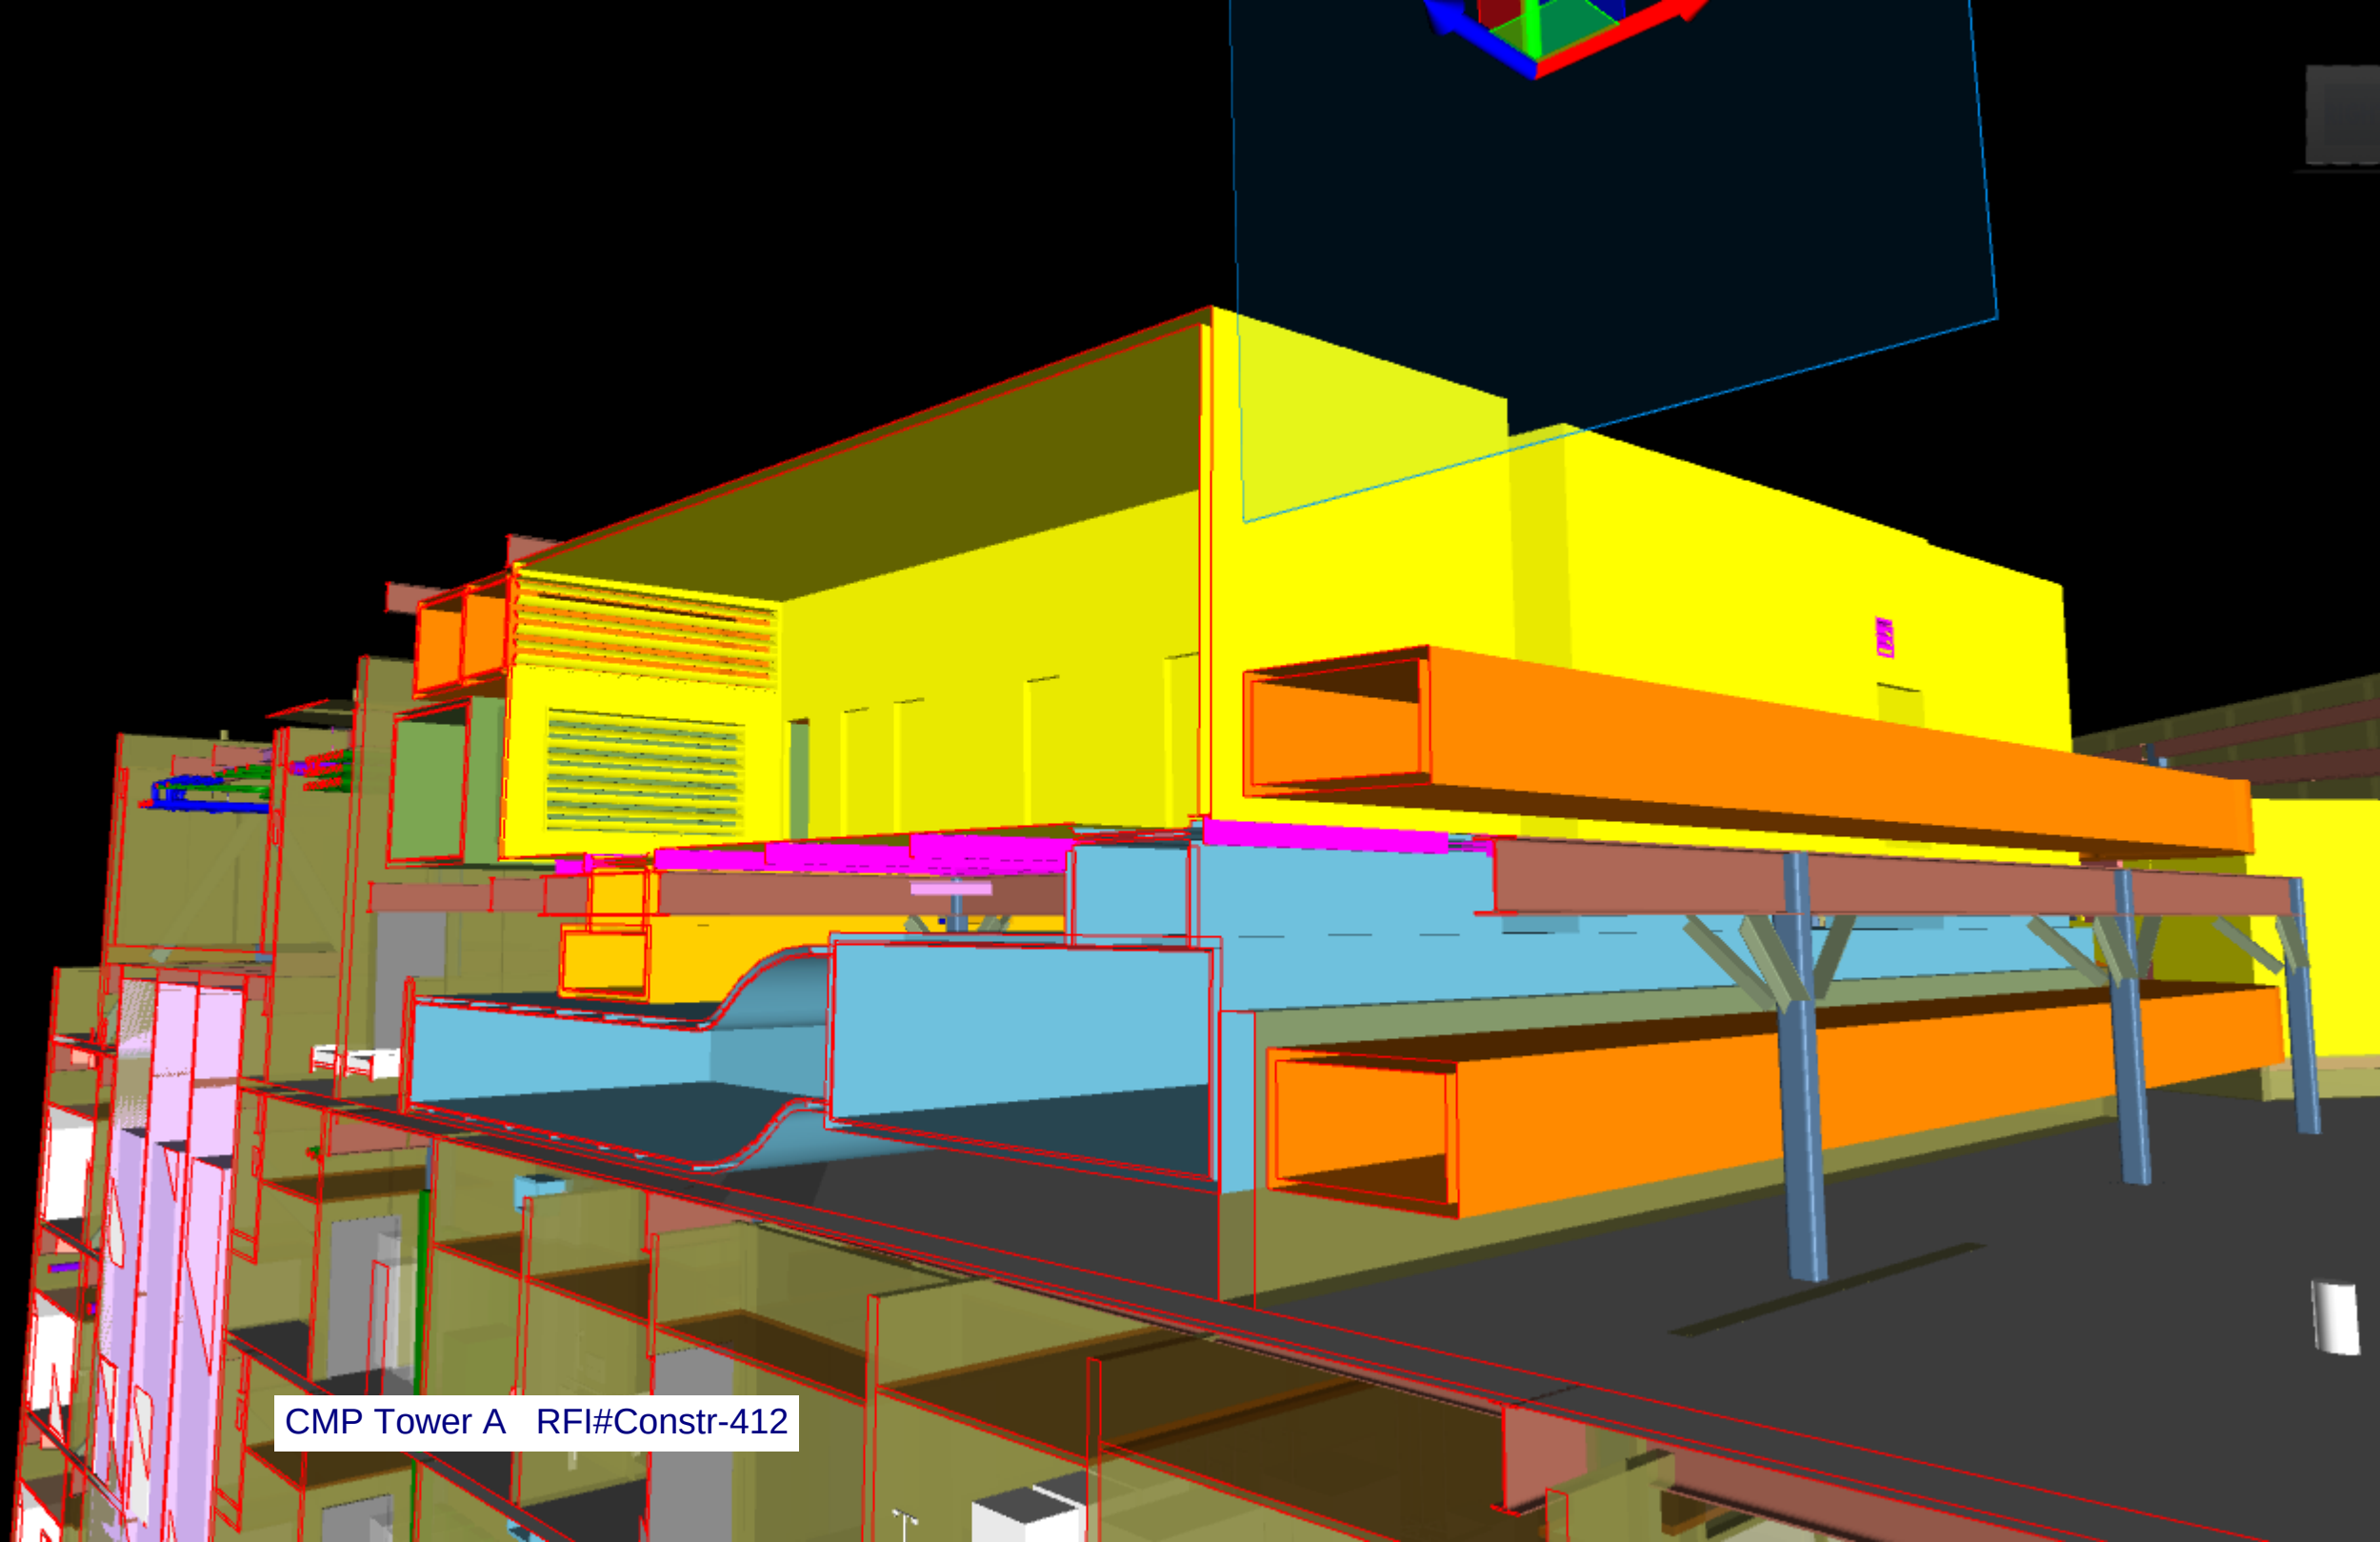

CMP Tower A RFI#Constr-412

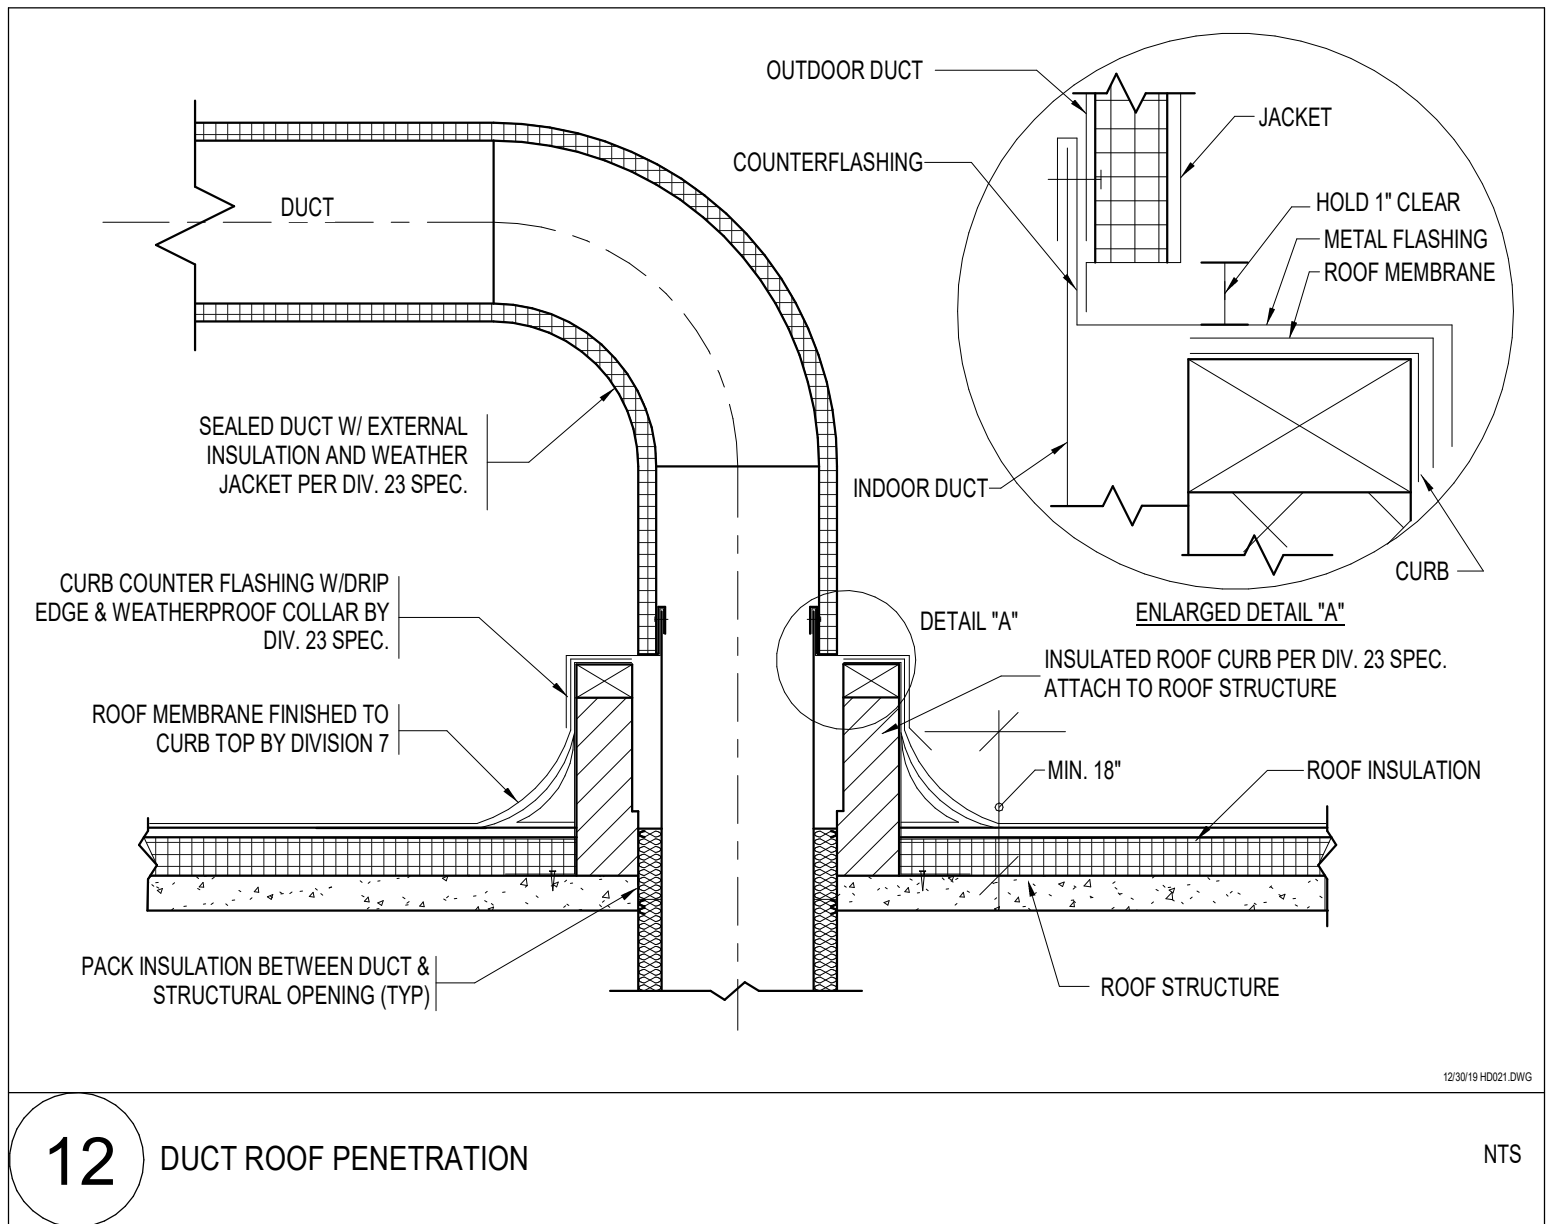



August 14, 2025

Torcon / P. Agnes
328 Newman Springs Road
Red Bank, NJ 07701

ATTN: Dan Thorley

RE: Cooper Hospital Tower A
101 Haddon Avenue
Camden, NJ 08103
Cives Change Alert #11 – Raising Dunnage Platform (RFI 313)

Dan:

Cives is in receipt of the response to RFI 313 and the email direction to raise the dunnage steel dated 8/11/25. We have assigned Cives Change Alert #11 to this information, and per your instructions have proceeded with the incorporation of these documents while pricing. Upon receipt of these documents, they were issued to our estimating department and subcontractors for review of cost and/or schedule impacts. Attached you will find a summary of that review.

Raising the dunnage steel by 2'9" as directed requires an additional 1.96 tons of new material to be purchased. There was a total of 26 posts that were extended as a result of these changes. Since the HSS material had not been ordered at the time of these revisions, all of the old posts were able to be credited back. For future changes, extending a post may require an entirely new post to be purchased with only a scrap credit for the old post. The change in length of these posts did not significantly impact the fabrication or erection costs. Increasing the length and weight of pieces causes a small increase in handling costs. For this small increase in length, these costs will be absorbed by Cives.

At the time of these revisions the entire dunnage area had already been modeled and connections were being incorporated. Raising the steel and extending the posts required additional detailing time to incorporate these changes. The detailing hours added as a result of the changes are shown in the attached contract amendment summary.

Our review of the changes in RFI 313 indicates a total **ADD** to our contract of **\$9,139** for which we request your change order. The summary of this amount is attached on the next page.

If you have any questions or comments, please do not hesitate to contact the undersigned.

Sincerely,
Cives Steel Company
Mid-Atlantic Division

A handwritten signature in black ink, appearing to read "Jonathan Blalack".

Jonathan Blalack
Project Engineer



Project: **Cooper Tower A**
Camden, NJ

Subject: **CA #11 - Raising Dunnage Platform**
Date: **8/14/2025**

CONTRACT AMENDMENT SUMMARY

<u>ITEM</u>	<u>QUANTITY</u>	<u>UNIT</u>	<u>AMOUNT</u>
Steel, Bolts & Paint	1.96 Tons		\$3,918.00
Warehouse Premium	1.96 Tons	\$400.00 Ton	\$784.00
Old / Unused Steel (Scrap)	0.00 Tons	\$0.05 lb.	\$0.00
Galvanizing	1.96 Tons	\$1,000.00 Ton	\$1,960.00
Metal Deck			\$0.00
Freight	39 Cwt.	\$5.65 Cwt.	\$221.00
Taxes	\$5,878.00	0.00%	\$0.00
MATERIAL TOTAL			<u>\$6,883.00</u>
Fabrication	0 Hrs.	\$120.00 /Hr.	\$0.00
Detailing	15 Hrs.	\$95.00 /Hr.	\$1,425.00
Engineering & Design	0 Hrs.	\$255.00 /Hr.	\$0.00
LABOR TOTAL			<u>\$1,425.00</u>
Material and Labor Subtotal			<u>\$8,308.00</u>
Mark-Up		10%	\$831.00
MATERIAL AND LABOR TOTAL			<u>\$9,139.00</u>
Erection			\$0.00
Mark-Up		5%	\$0.00
FIELD LABOR TOTAL			<u>\$0.00</u>
Insurance	0.00	\$6.025 /1000	\$0.00
Payment & Performance Bond	0.00	\$7.25 /1000	\$0.00
CONTRACT AMENDMENT TOTAL			<u>\$9,139.00</u>



CHANGE ORDER REQUEST

To: Torcon/P. Agnes A Joint Venture
328 Newman Springs Road
Red Bank, NJ 077010

Date: 8/20/2025
Job #: 2517
CO#: 5
Description: RFI-113 Dunnage Change

Attn: David Hontz

Re: Cooper Tower A
1 Cooper Plaza
Camden New Jersey 08103

This change affects the schedule by (0) weeks

Price assumes all work to be done on normal hours
No other work will commence prior to approval

Item	Description	Mtl.	Shop	Field
1	Fabricated Galvanized Ductwork Deduct EF-5 Riser 1811 LBS @ \$ 8.79	\$15,918.69		72.44
2				
3				
Totals	\$15,918.69	0	72.44
--------	-------------	---	-------

\$15,919	Material Cost Plus	0%	Tax =	\$15,918.69
0	Shop Journeyman MH @		Per MH =	\$0.00
0	Shop Super MH @		Per MH =	\$0.00
54.33	Field Journeyman MH @	\$121.45	Per MH =	\$6,598.38
18.11	Field Foreman MH @	\$126.19	Per MH =	\$2,285.30
16	Sketching MH @	\$126.19	Per MH =	\$2,019.04
0	Lift/High Reach Hours			\$0.00

WAGE RATES EXPIRE 4/30/2026

Subcontractors

Total Cost	\$26,821.41
Mark-Up 15%	\$4,023.21
Total Value of This Change Order Request	\$30,844.62

Notes:

6" W.G.



PROJECT: Cooper Tower A
SYSTEM: AH-1,2,3,4

DWG/SYS	W	H	L	LBS
M1.11-CS	134	62	3	549
M1.11-CS	144	76	3	617
M1.11-CS	164	66	3	645
				0
				0
	TOTALS			1811

Antonio Andreoni

From: Al Nanni <ananni@falascamechanical.com>
Sent: Tuesday, September 2, 2025 3:58 PM
To: Antonio Andreoni
Cc: Al Nanni Jr
Subject: RE: [EXT] FW: RFI #Constr-313: CS - Roof Ductwork and Dunnage Coordination

Tony, We are good with the RFI. We have an small increase in pipe length to 12 lines total but it's not enough to be concerned with. Our sketcher feels the same way.

Thanks

Al Nanni
Project Manager



Falasca Mechanical Inc.
3329 North Mill Road
Vineland, NJ 08360
856-794-2010 Ext. 111
856-794-9644 Fax
609-774-5121 Cell

From: Antonio Andreoni <aandreoni@torcon.com>
Sent: Tuesday, September 2, 2025 12:01 PM
To: Al Nanni <ananni@falascamechanical.com>
Cc: Al Nanni Jr <anannijr@falascamechanical.com>
Subject: RE: [EXT] FW: RFI #Constr-313: CS - Roof Ductwork and Dunnage Coordination

CAUTION: This email originated from outside of your organization. Do not click links or open attachments unless you recognize the sender and know the content is safe.

Any update?

Torcon, Inc.

Antonio Andreoni
PROJECT ENGINEER

T 732.704.9800
C 267.995.6729